


画地出来形確認測量原図




拡大図 $S = 1 : 100$

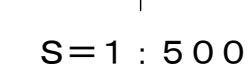



北部大阪都市計画事業真砂・玉島台土地区画整理事業

街区出来形確認測量原図

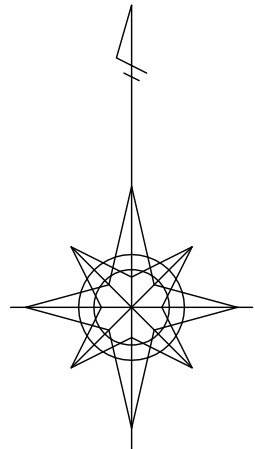


S=1:500

拡大図 S=1:100

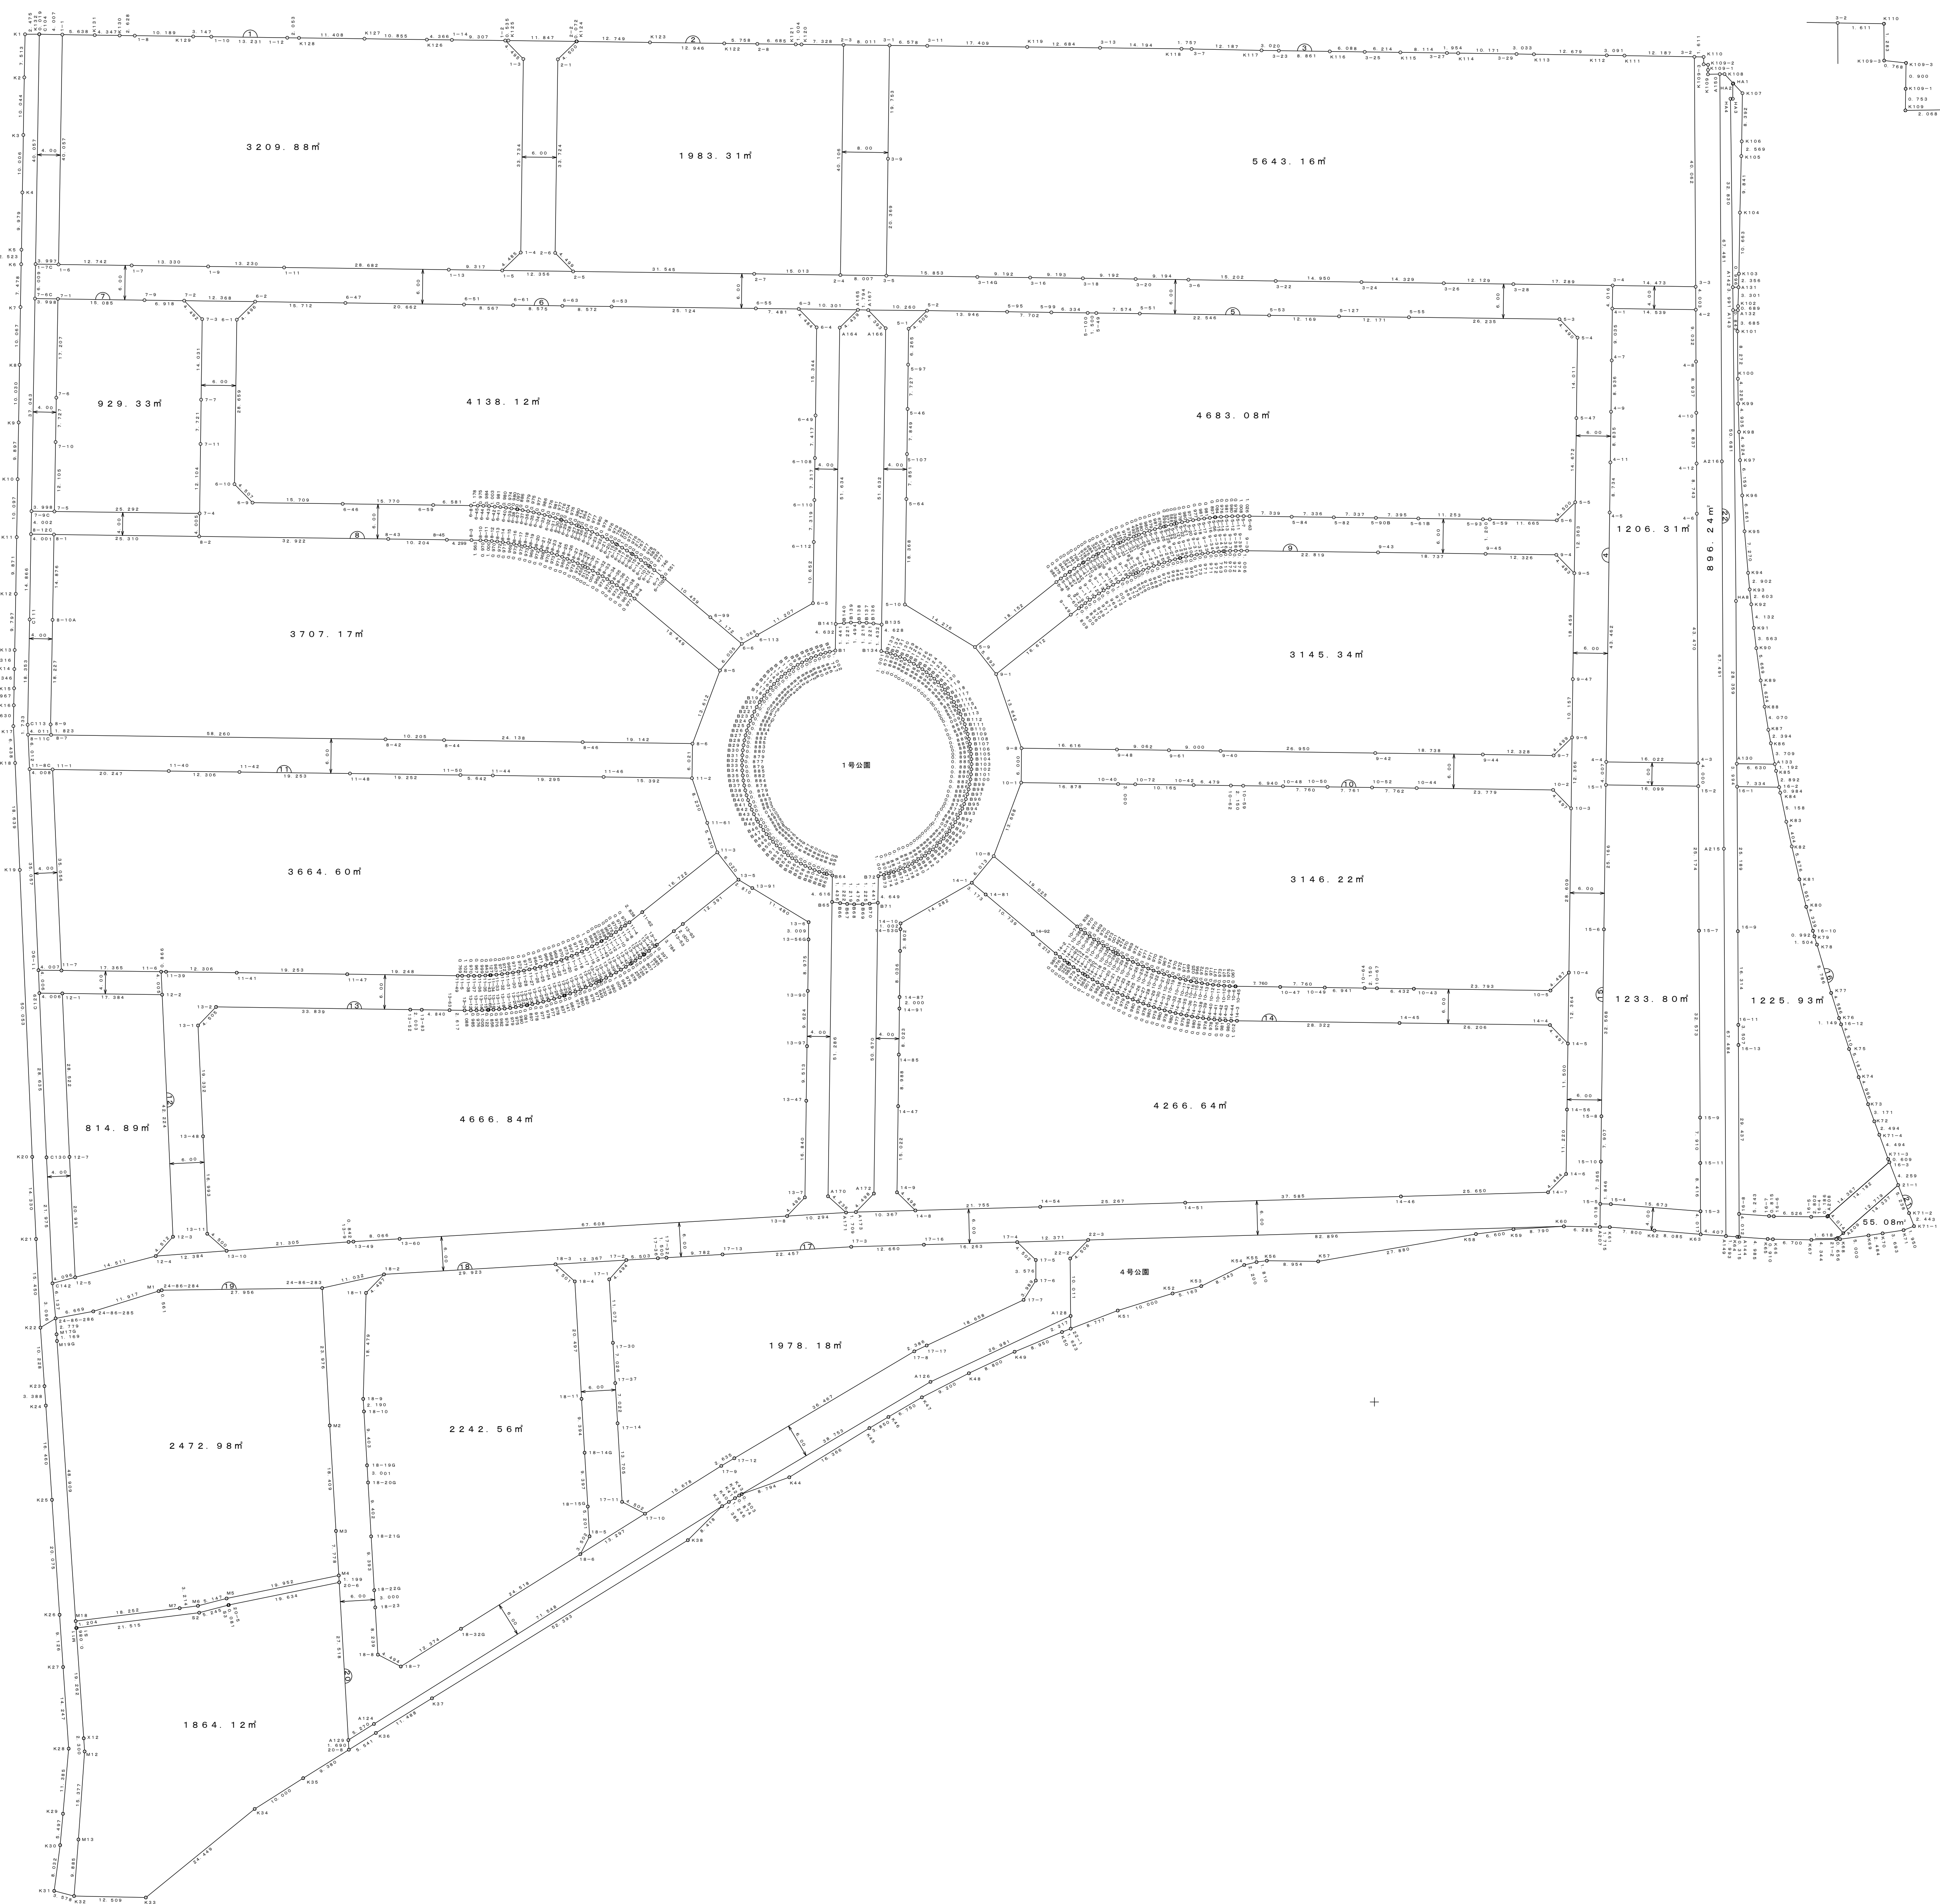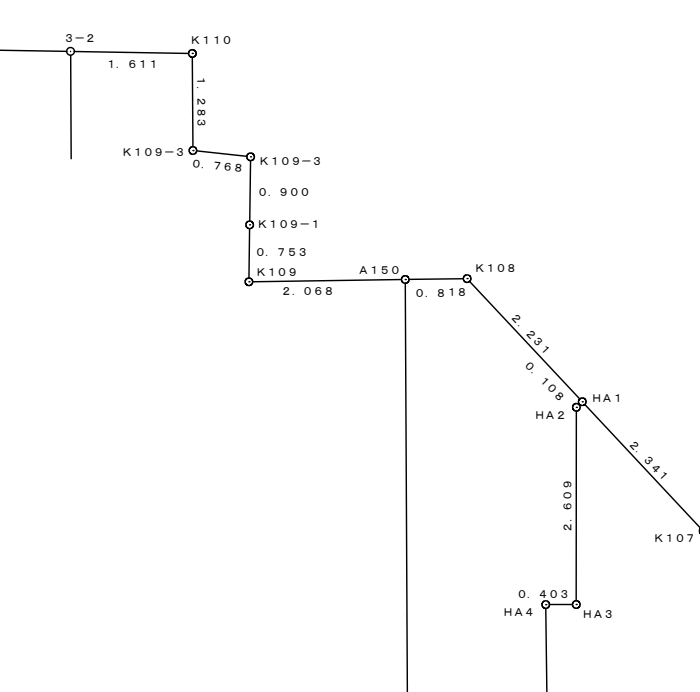


北部大阪都市計画事業真砂・玉島台土地区画整理事業

公共用地出来形確認測量原図

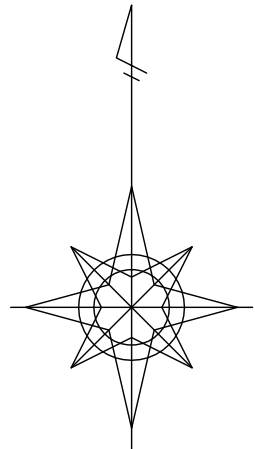

S=1:500

拡大図 S=1:100

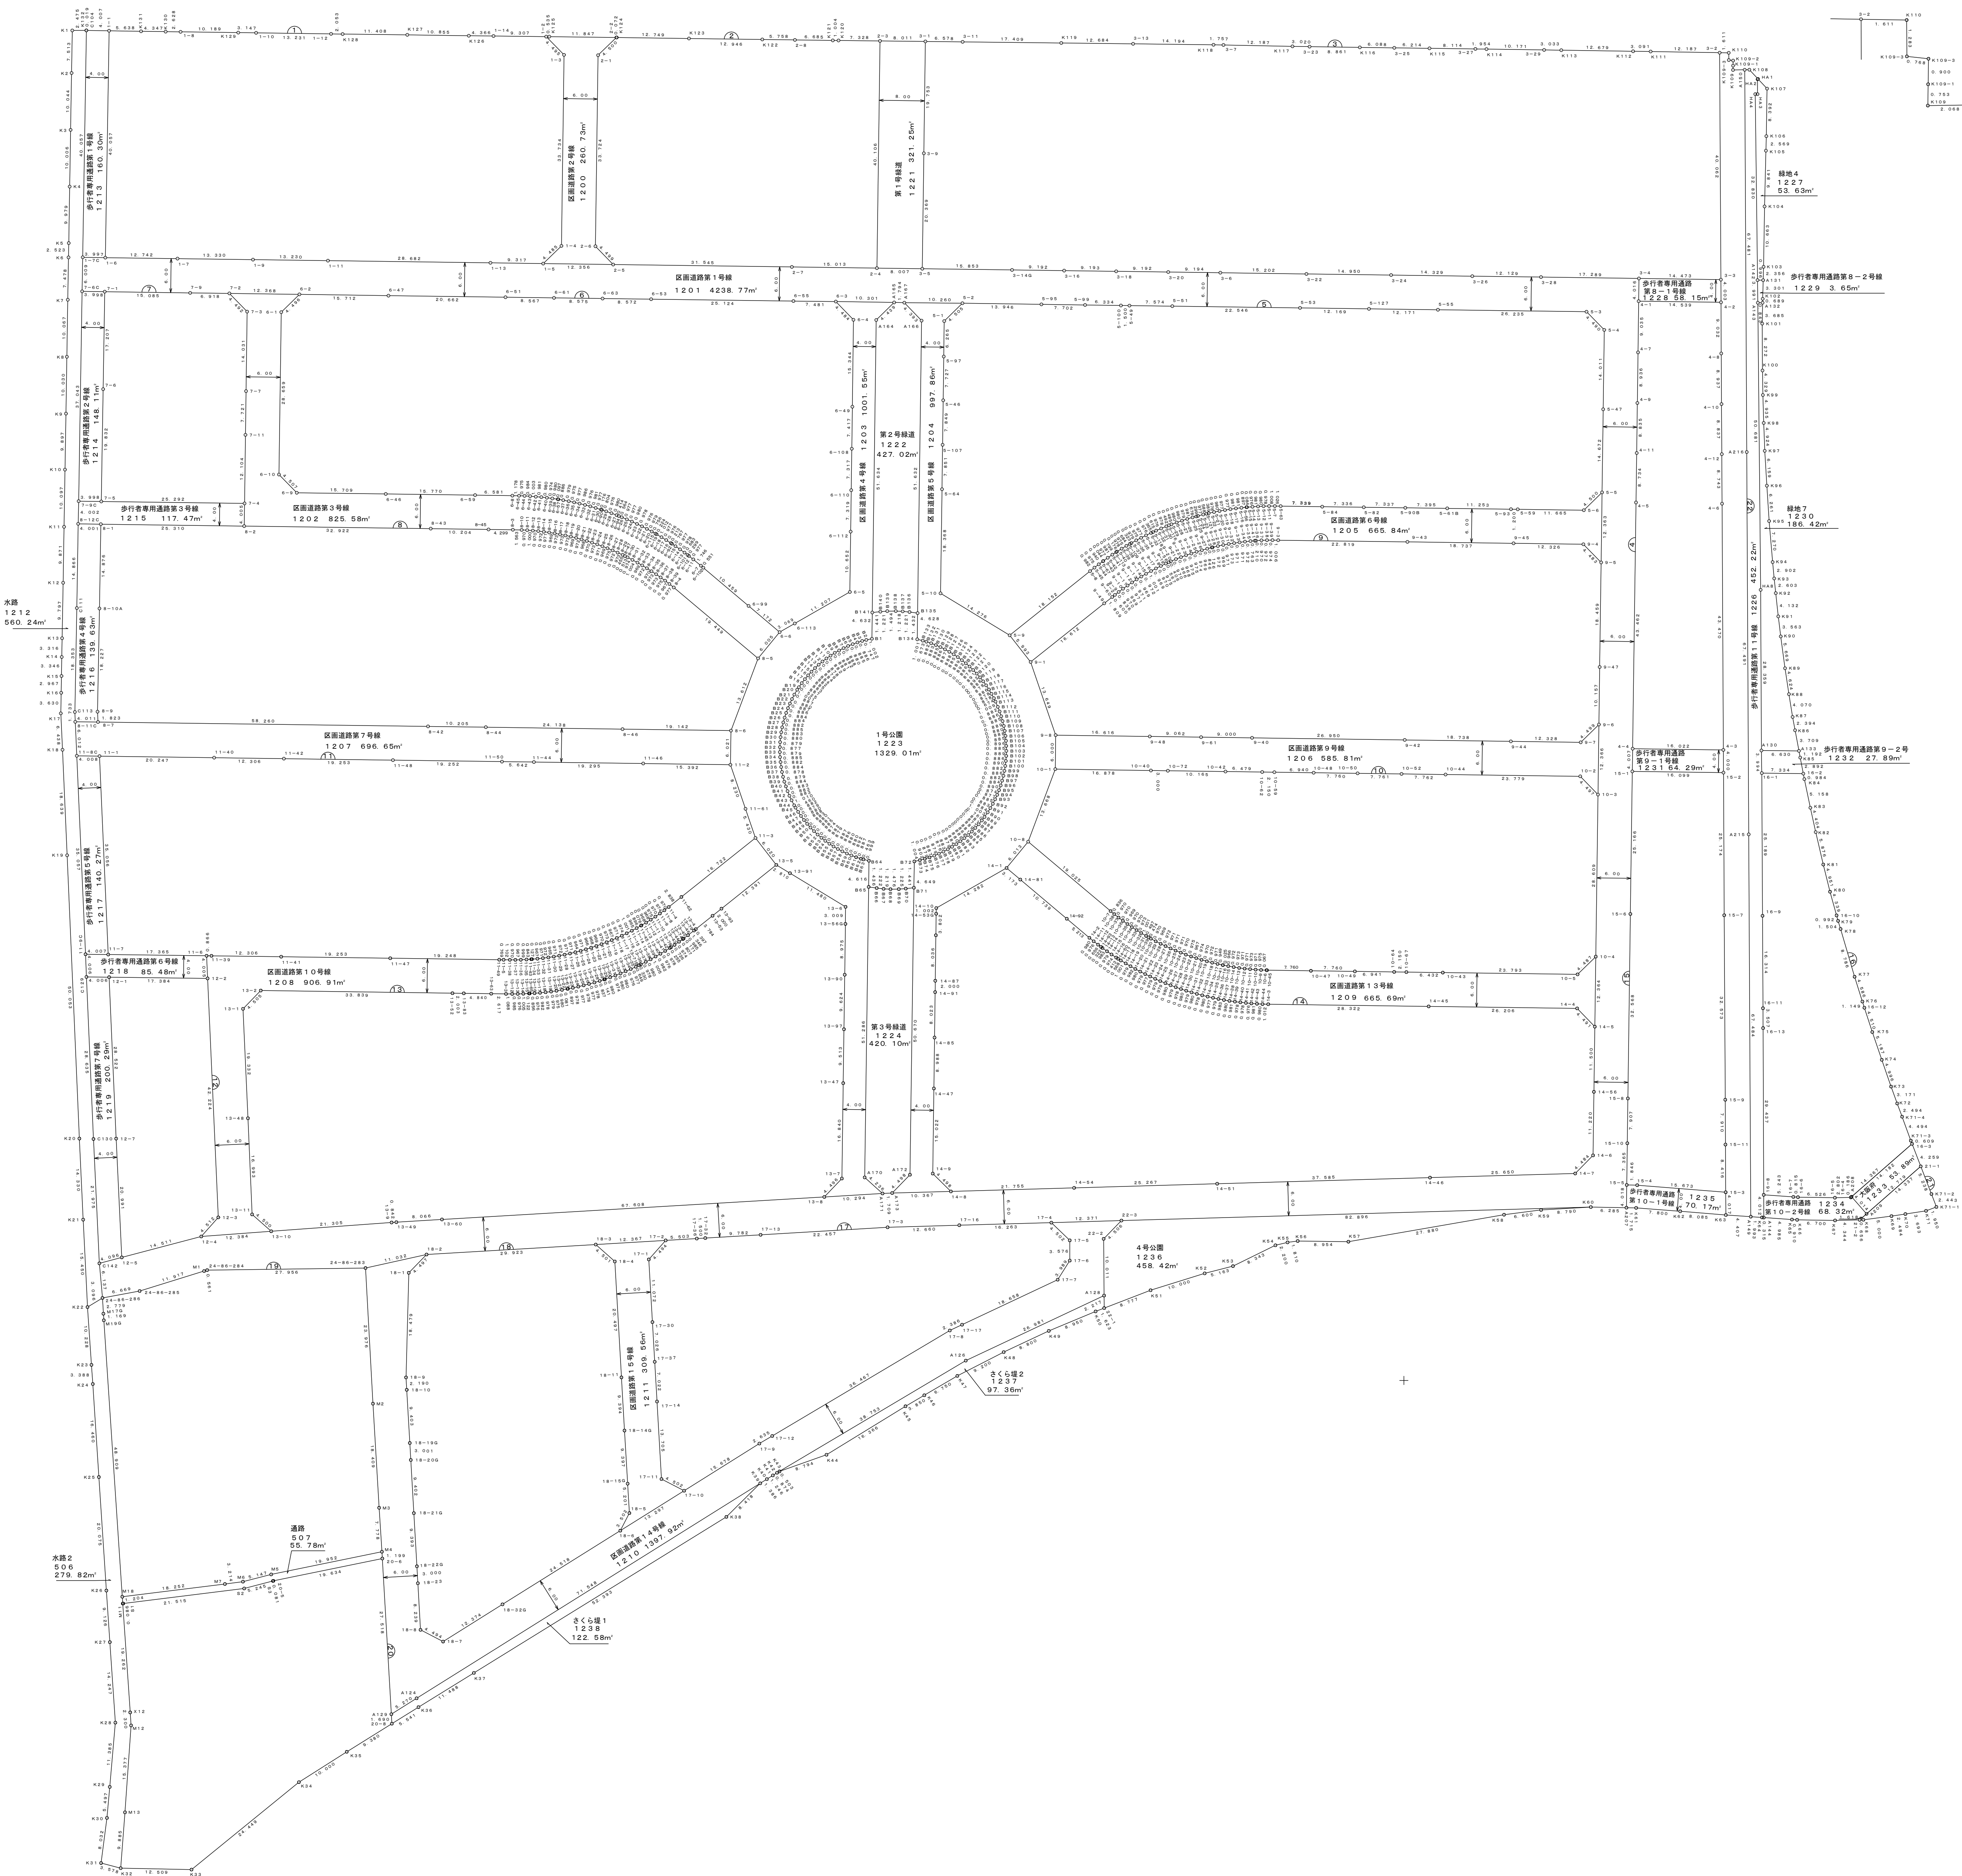

面積一覽表

地番	面積
500	99.9717075 m ²
501	1491.105334 m ²
502	881.9031835 m ²
503	487.972617 m ²
504	778.0038055 m ²
505	598.152008 m ²
1000	507.655605 m ²
1001	533.8143635 m ²
1002	529.6765285 m ²
1003	1148.305695 m ²
1004	490.428147 m ²
1005	1381.3650775 m ²
1006	601.947828 m ²
1007	130.0786215 m ²
1008	595.678539 m ²
1009	316.399165 m ²
1010	322.9095005 m ²
1011	187.233203 m ²
1012	187.2423945 m ²
1013	187.2330265 m ²
1014	187.238744 m ²
1015	610.6766615 m ²
1016	599.7636595 m ²
1017	574.783239 m ²
1018	486.3860395 m ²
1019	1257.540152 m ²
1020	896.2424935 m ²
1021	132.006285 m ²
1022	132.009256 m ²
1023	132.0044035 m ²
1024	132.0082845 m ²
1025	678.2871385 m ²
1026	260.0095715 m ²
1027	2.400432 m ²
1028	220.0464075 m ²
1029	132.0770605 m ²
1030	131.070816 m ²
1031	131.0785485 m ²
1032	131.0744485 m ²
1033	108.185391 m ²
1034	131.619218 m ²
1035	3.665209 m ²
1036	130.9593375 m ²
1037	131.185802 m ²
1038	130.4650625 m ²
1039	135.2538395 m ²
1040	130.209868 m ²
1041	522.2422965 m ²
1042	130.3219625 m ²
1043	130.3121735 m ²
1044	132.245880 m ²
1045	156.806000 m ²
1046	132.2425695 m ²
1047	132.253184 m ²
1048	2.2511805 m ²
1049	130.0023005 m ²
1050	387.0798455 m ²
1051	208.9245985 m ²
1052	208.933211 m ²
1053	382.592885 m ²
1054	158.711910 m ²
1055	158.712887 m ²
1056	158.735746 m ²
1057	464.883472 m ²
1058	192.103964 m ²
1059	132.4082675 m ²
1060	130.601187 m ²
1061	130.605809 m ²
1062	130.331927 m ²
1063	131.885482 m ²
1064	130.1555555 m ²

面積一覽表

地番	面積
1065	130.766544 m ²
1066	147.4124305 m ²
1067	4.535820 m ²
1068	130.148817 m ²
1069	130.9325465 m ²
1070	137.212324 m ²
1071	243.9783295 m ²
1072	260.0074055 m ²
1073	651.3976135 m ²
1074	168.521644 m ²
1075	260.004400 m ²
1076	194.9106395 m ²
1077	305.8981475 m ²
1078	2035.5306545 m ²
1079	356.209534 m ²
1080	815.3534835 m ²
1081	500.0831655 m ²
1082	301.001136 m ²
1083	2.6674155 m ²
1084	138.269590 m ²
1085	132.8785655 m ²
1086	133.7522365 m ²
1087	160.065993 m ²
1088	148.0565795 m ²
1089	941.7776175 m ²
1090	655.098004 m ²
1091	330.008961 m ²
1092	201.769717 m ²
1093	932.581647 m ²
1094	133.901902 m ²
1095	3.010616 m ²
1096	134.578105 m ²
1097	135.718697 m ²
1098	135.735148 m ²
1099	134.419043 m ²
1100	135.6421825 m ²
1101	135.610996 m ²
1102	135.606206 m ²
1103	134.460977 m ²
1104	3.009970 m ²
1105	134.6076815 m ²
1106	134.6164965 m ²
1107	145.1913715 m ²
1108	144.2066315 m ²
1109	433.3387755 m ²
1110	130.0071305 m ²
1111	130.005079 m ²
1112	130.0003975 m ²
1113	627.525853 m ²
1114	197.192353 m ²
1115	673.190148 m ²
1116	673.194961 m ²
1117	430.3536755 m ²
1118	673.127085 m ²
1119	814.899067 m ²
1120	785.456879 m ²
1121	160.089028 m ²
1122	1412.924342 m ²
1123	4.000903 m ²
1124	130.2461075 m ²
1125	130.239724 m ²
1126	130.2394525 m ²
1127	130.2300205 m ²
1128	137.090287 m ²
1129	130.227641 m ²
1130	130.461960 m ²
1131	142.3187875 m ²
1132	130.2373425 m ²
1133	3.000554 m ²
1134	163.1688945 m ²
1135	147.477837 m ²

面積一覽表

地番	面積
1136	146.2655995 m ²
1137	153.0920385 m ²
1138	130.4387785 m ²
1139	131.261347 m ²
1140	4.000676 m ²
1141	131.4507135 m ²
1142	130.805929 m ²
1143	136.158531 m ²
1144	183.8118065 m ²
1145	200.068959 m ²
1146	441.262174 m ²
1147	441.2711445 m ²
1148	854.0978845 m ²
1149	631.399470 m ²
1150	500.768394 m ²
1151	349.845930 m ²
1152	136.4770505 m ²
1153	136.4798825 m ²
1154	549.736206 m ²
1155	411.109148 m ²
1156	251.963817 m ²
1157	973.9743575 m ²
1158	55.086470 m ²
1159	250.7110895 m ²
1160	923.691214 m ²
1161	243.7801205 m ²
1162	140.1874955 m ²
1163	140.181768 m ²
1164	139.6050955 m ²
1165	2.250954 m ²
1166	137.774492 m ²
1167	869.324742 m ²
1168	136.7171385 m ²
1169	136.744379 m ²
1170	315.065098 m ²
1171	159.0405375 m ²
1172	3.269729 m ²
1173	138.1397415 m ²
1174	138.237462 m ²
1175	207.7503695 m ²
1176	138.2745985 m ²
総計	56173.631614 m ²